


PARCEL NO. 07-027.00-008

MICROFILM No.: 856

DEED REF: 20050428-0040126

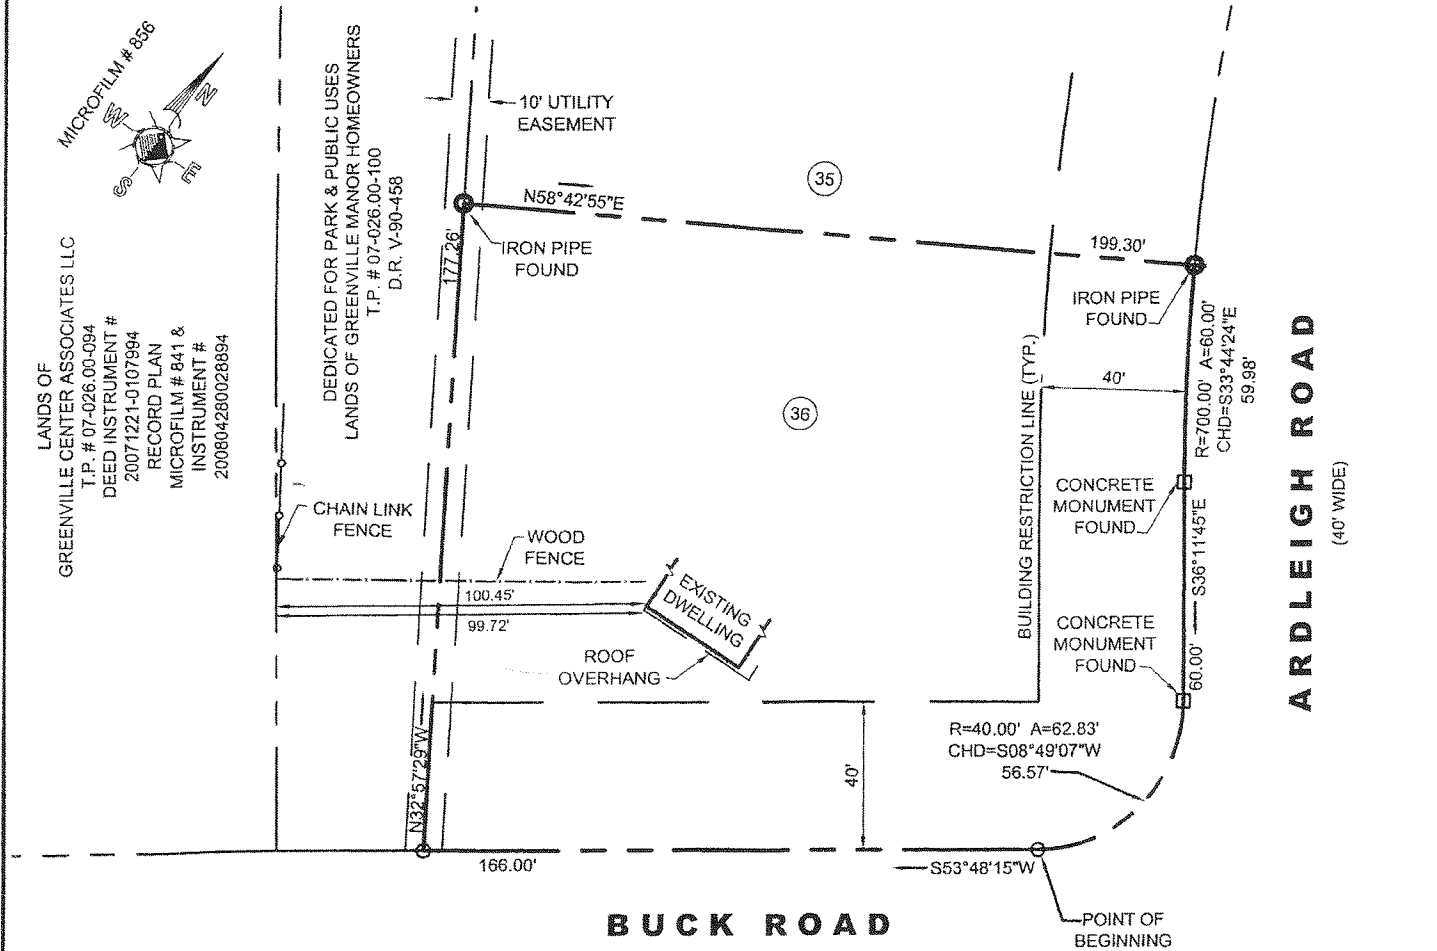

MICROFILM # 856

LANDS OF GREENVILLE CENTER ASSOCIATES LLC
 T.I.P. # 07-026.00-094
 DEED INSTRUMENT # 20071221-0107994
 RECORD PLAN MICROFILM # 841 & INSTRUMENT # 200804280028894

DEDICATED FOR PARK & PUBLIC USES
 LANDS OF GREENVILLE MANOR HOMEOWNERS
 T.I.P. # 07-026.00-100
 D.R. V-90-458

LOCATION PLAN
 SHOWING DISTANCES FROM DWELLING AT 3800
 ARDLEIGH DRIVE TO LANDS OF GREENVILLE
 CENTER ASSOCIATES LLC

FROM PROPERTY KNOWN AS:
 LOT No. 36 * GREENVILLE MANOR
 ALSO KNOWN AS:
 3800 ARDLEIGH DRIVE
 SITUATE IN:
 CHRISTIANA HUNDRED * NEW CASTLE COUNTY
 STATE OF DELAWARE
 SCALE: 1"=50'
 DATE: 20 APRIL 2010

Michael A. Edg
 PROFESSIONAL LAND SURVEYOR
 DATE 4/21/2010

MERESTONE CONSULTANTS, INC.
 ENGINEERS - PLANNERS - SURVEYORS

5215 WEST WOODMILL DRIVE WILMINGTON, DE 19808 PHONE: 302-992-7900
 19633 BLUE BIRD LANE, SUITE 7 REHOBOTH BEACH, DE 19971 PHONE: 302-226-5880